

PILKHANI ← → SAHNEWAL

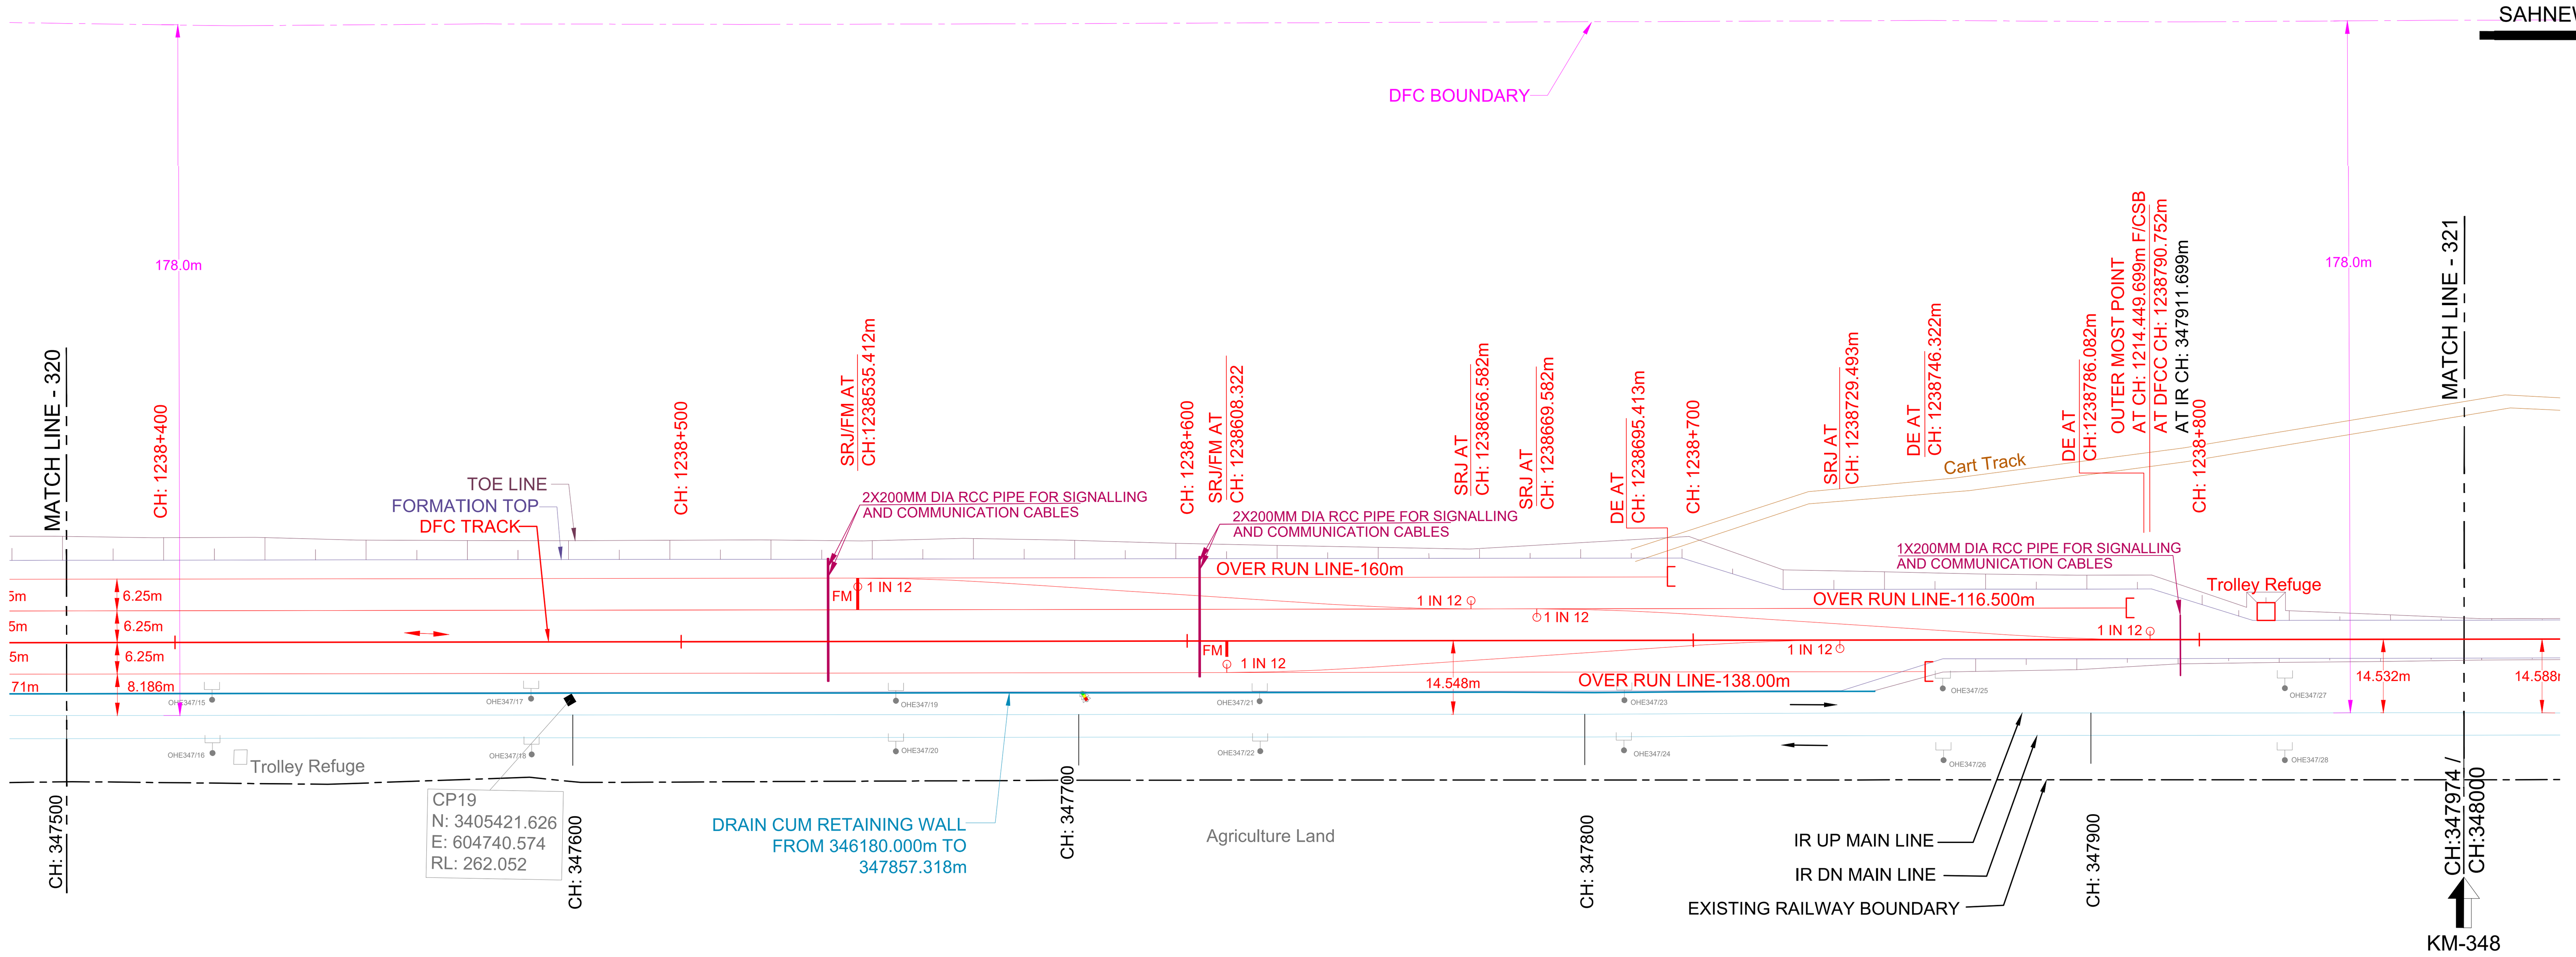

PLAN
1:1000

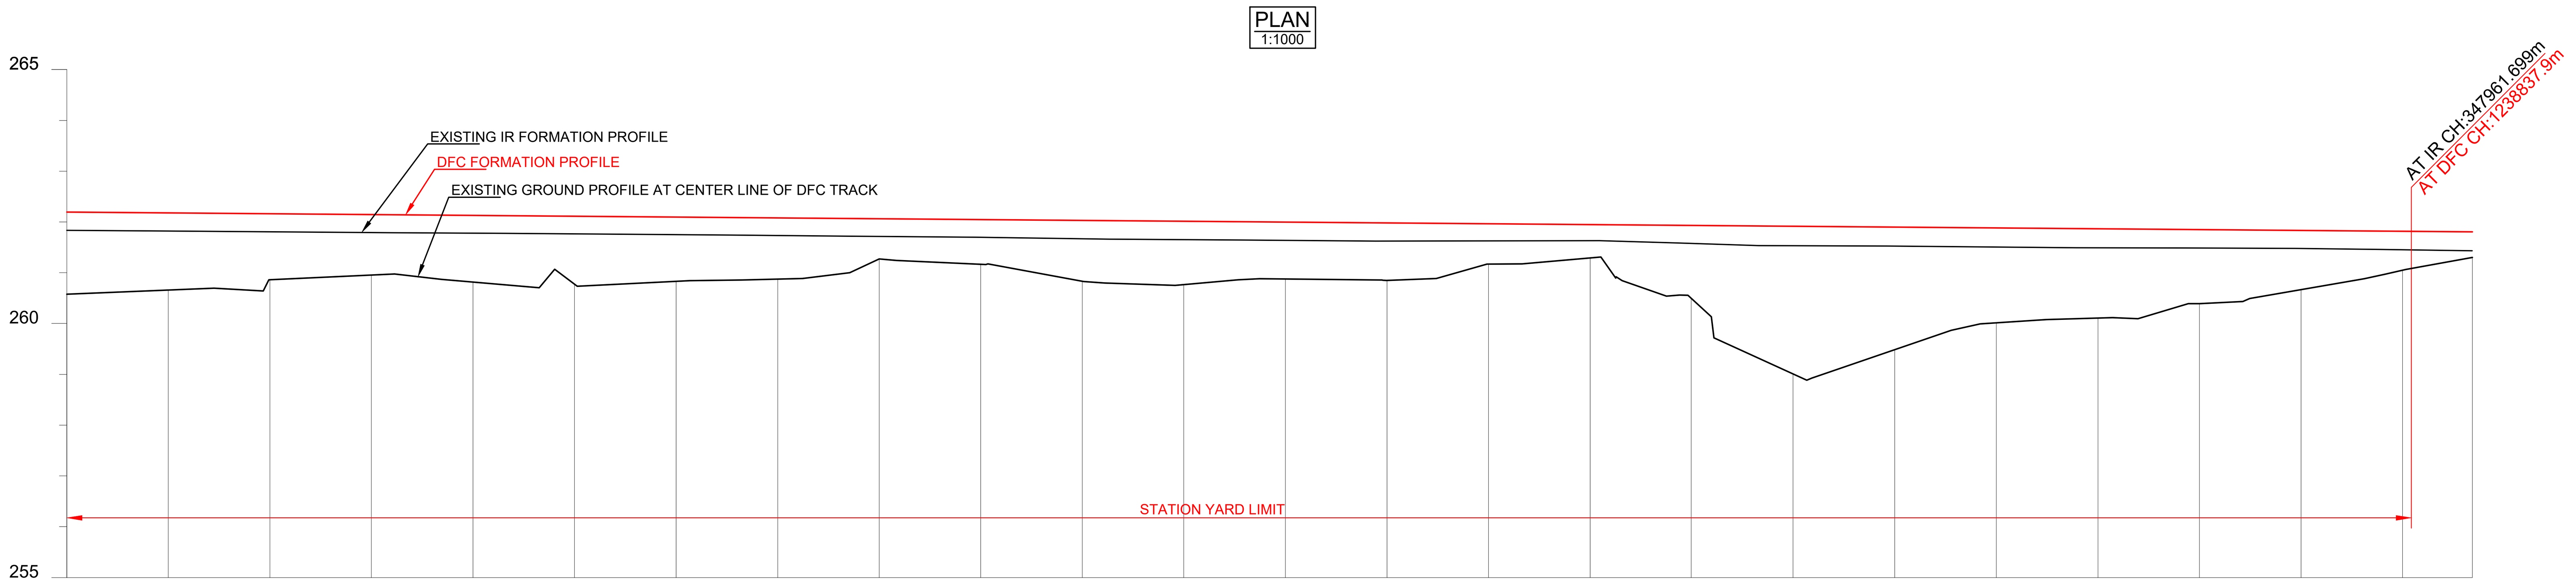

DATUM ABOVE MSL : 255 m

HORIZONTAL ALIGNMENT	L = 3014.655m
VERTICAL ALIGNMENT	L=2484.775 m 1 IN 1219.242 F

TRACK DISTANCE FROM EXISTING NEAREST IR UP MAIN LINE TO DFC MAIN LINE	14.429	14.442	14.439	14.444	14.446	14.447	14.456	14.470
HEIGHT OF BANKING(+) / DEPTH OF CUTTING(-) (PFL-GL)	+1.619	+1.519	+1.301	+1.191	+1.315	+1.341	+1.264	+1.205
EXG GROUND LEVEL AT CENTER LINE OF DFC TRACK (GL)	260.577	260.660	260.862	260.955	260.815	260.773	260.833	260.876
EXG GROUND LEVEL AT TOE LOCATION OF DFC TRACK	259.734	259.878	259.850	260.128	260.139	260.137	260.112	260.055
DIFFERENCE BETWEEN DFC FORMATION LEVEL AND EXG.FORMATION LEVEL.(PFL-EFL)	0.361	0.356	0.355	0.353	0.349	0.348	0.347	0.348
DFC FORMATION LEVEL (PFL)	262.196	262.179	262.163	262.146	262.130	262.114	262.097	262.081
EXG. FORMATION LEVEL OF EXG IR UP MAIN LINE (EFL)	261.835	261.823	261.808	261.793	261.781	261.766	261.750	261.733
DIFFERENCE BETWEEN DFC RAIL LEVEL AND EXG. RAIL LEVEL (PRL - ERL)	0.403	0.398	0.396	0.395	0.391	0.390	0.389	0.390
DFC RAIL LEVEL (PRL)	262.910	262.893	262.877	262.860	262.844	262.827	262.811	262.795
EXG.RAIL LEVEL OF NEAREST IR UP MAIN LINE(ERL)	262.507	262.495	262.480	262.465	262.453	262.438	262.422	262.405
EQUIVALENT CHAINAGE ON DFC TRACK	1238377.9	1238397.9	1238417.9	1238437.9	1238457.9	1238477.9	1238497.9	1238517.9
EXISTING IR CHAINAGE	347500.0	347520.0	347540.0	347560.0	347580.0	347600.0	347620.0	347640.0

TRACK DISTANCE FROM EXISTING NEAREST IR UP MAIN LINE TO DFC MAIN LINE	14.484	14.494	14.508	14.513	14.516	14.522	14.560	14.597
HEIGHT OF BANKING(+) / DEPTH OF CUTTING(-) (PFL-GL)	+0.793	+0.883	+1.200	+1.249	+1.122	+1.134	+0.795	+0.660
EXG GROUND LEVEL AT CENTER LINE OF DFC TRACK (GL)	261.271	261.165	260.832	260.766	260.877	260.848	261.171	261.290
EXG GROUND LEVEL AT TOE LOCATION OF DFC TRACK	260.131	259.903	260.110	260.418	260.609	260.799	261.000	261.191
DIFFERENCE BETWEEN DFC FORMATION LEVEL AND EXG.FORMATION LEVEL.(PFL-EFL)	0.349	0.349	0.361	0.363	0.361	0.357	0.339	0.320
DFC FORMATION LEVEL (PFL)	262.064	262.048	262.032	262.015	261.999	261.982	261.966	261.950
EXG. FORMATION LEVEL OF EXG IR UP MAIN LINE (EFL)	261.715	261.699	261.671	261.652	261.638	261.625	261.627	261.630
DIFFERENCE BETWEEN DFC RAIL LEVEL AND EXG. RAIL LEVEL (PRL - ERL)	0.392	0.391	0.403	0.405	0.403	0.399	0.381	0.361
DFC RAIL LEVEL (PRL)	262.778	262.762	262.745	262.729	262.713	262.696	262.680	262.663
EXG.RAIL LEVEL OF NEAREST IR UP MAIN LINE(ERL)	262.387	262.371	262.343	262.324	262.310	262.297	262.299	262.302
EQUIVALENT CHAINAGE ON DFC TRACK	1238537.9	1238557.9	1238577.9	1238597.9	1238617.9	1238638.0	1238658.0	1238678.0
EXISTING IR CHAINAGE	347660.0	347680.0	347700.0	347720.0	347740.0	347760.0	347780.0	347800.0

TRACK DISTANCE FROM EXISTING NEAREST IR UP MAIN LINE TO DFC MAIN LINE	14.516	14.448	14.437	14.455	14.475	14.503	14.530	14.533	14.535
HEIGHT OF BANKING(+) / DEPTH OF CUTTING(-) (PFL-GL)	+1.435	+2.908	+2.414	+1.871	+1.760	+1.461	+1.170	+0.768	+0.506
EXG GROUND LEVEL AT CENTER LINE OF DFC TRACK (GL)	260.498	259.009	259.486	260.013	260.108	260.390	260.665	261.050	261.301
EXG GROUND LEVEL AT TOE LOCATION OF DFC TRACK	260.709	259.484	259.934	260.230	260.313	260.309	260.714	261.081	261.300
DIFFERENCE BETWEEN DFC FORMATION LEVEL AND EXG.FORMATION LEVEL.(PFL-EFL)	0.357	0.385	0.377	0.378	0.377	0.365	0.356	0.364	0.376
DFC FORMATION LEVEL (PFL)	261.933	261.917	261.900	261.884	261.868	261.851	261.835	261.818	261.807
EXG. FORMATION LEVEL OF EXG IR UP MAIN LINE (EFL)	261.576	261.532	261.523	261.506	261.491	261.486	261.479	261.454	261.431
DIFFERENCE BETWEEN DFC RAIL LEVEL AND EXG. RAIL LEVEL (PRL - ERL)	0.399	0.426	0.419	0.420	0.418	0.408	0.398	0.406	0.418
DFC RAIL LEVEL (PRL)	262.647	262.631	262.614	262.598	262.581	262.565	262.549	262.532	262.521
EXG.RAIL LEVEL OF NEAREST IR UP MAIN LINE(ERL)	262.248	262.204	262.195	262.178	262.163	262.158	262.151	262.126	262.103
EQUIVALENT CHAINAGE ON DFC TRACK	1238697.9	1238717.9	1238737.9	1238757.9	1238777.9	1238797.9	1238817.9	1238837.9	1238851.7
EXISTING IR CHAINAGE	347820.0	347840.0	347860.0	347880.0	347900.0	347920.0	347940.0	347960.0	347973.7 348000.0

L - SECTION

DRG NO.- 301-2/AL/A/1321

NOTE:-

1. DFCC WORKS ARE SHOWN IN RED.
2. IR NEW WORKS ARE SHOWN IN VIOLET.
3. ALL DIMENSIONS ARE SHOWN IN METRES.
4. THIS DRAWING IS PREPARED BASED ON LATEST SURVEY DATA HELD ON APRIL-2022. GTS BENCH MARK OF 261.850M CONSIDERED ON TOP OF CANAL BRIDGE ABUTMENT AT DORAHA VILLAGE ALONG THE NH1.
5. DFC NEW CHAINAGE OF 1075.950M IS WITH REFERENCE TO THE IR KM OF 187.500KM END OF KM OF CP-303(SECTION P-3 PILKHANI END) AGAINST THE EXISTING DFC CHAINAGE. 116277.742M ISSUED VIDE LETTER NO. CGM/DFCC/UMB/SURVEY/2021-301-230116-011173 DT. 17.01.2023
6. BALLAST PROFILE HAS BEEN PROVIDED ACCORDING TO THE CLAUSE 1.11.3 OF STANDARD SCHEDULE OF DIMESION(EASTERN CORRIDOR) & THE BALLAST CUSHION DIMESION SHOWN IN 35CM ON GE-14 PARA 17. SPECIFICATIONS & RECOMMENDATIONS 2. TWO LAYER SYSTEM FIG.10.

REFERENCE DRAWINGS :-


1. FOR KEY PLAN REFER DRAWING NO. 301-2/AL/0001
2. FOR LEGEND AND ABBREVIATIONS REFER DRAWING NO. 301-2/AL1000
3. FOR TYPICAL SECTION OF BALLAST PROFILE (FL-RL) REFFER DRG. NO. 301-2/TK/TFD/-004 (TR.1952)

REV.	DATE	REVISION DETAILS	PURPOSE OF ISSUE
0	10.10.2024	SUBMISSION OF AS-BUILT DRAWING	FOR APPROVAL

SCALE
HOR - 1:1000 (0 10 20 30 40m)
VER - 1:100 (0 1 2 3 4m)
SHEET SIZE : A1

LEGEND:

- IR TRACK
- DFCC TRACK
- DFCC FUTURE PROPOSALS
- STRUCTURE / BUILDING
- DFCC TOE LINE
- DFCC FORMATION
- RETAINING WALL
- ROAD
- STREAM, DRAIN, NALA, CANAL.
- FENCE
- POWER LINES
- TBM
- ELECTRIC POLE/OHE MAST
- IR RAILWAY BOUNDARY
- DFCC BOUNDARY

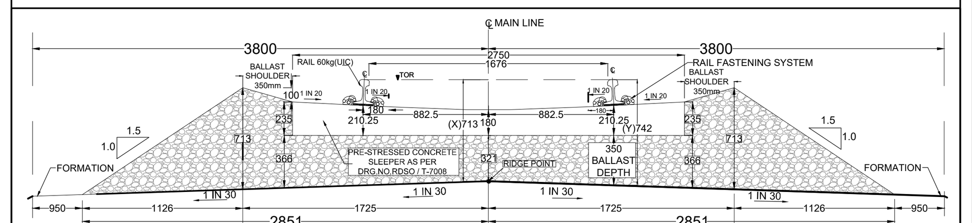

TYPICAL SECTION

TRACK STRUCTURE

	Difference between FL- RL (Below Rail Seat)	
RAIL SECTION: 60Kg/m (UIC 60Kg/m) DFC LINE: 60Kg/m (UIC 60Kg/m) IR MAIN LINE:52Kg/m	IR Line	DFC
	172mm	172mm
RUBBER PAD	6mm	10mm
SLEEPER DEPTH	210mm	210mm
BALLAST CUSHION	300mm	350mm
Total Depth (FL TO RL)	688mm	742mm

OWNER
DEDICATED FREIGHT CORRIDOR CORPORATION OF INDIA LTD.
(A GOVERNMENT OF INDIA ENTERPRISE)
PROJECT OFFICE(AMBALA UNIT): OLD RAILWAY COLONY (NEAR ANAND MARKET),AMBALA CANTT-133001.
CORPORATE IDENTITY NO. : U60232DL2006GOI155068

ENGINEER:
DB Engineering & Consulting GmbH
Deutsche Bahn Engineering & Consulting GmbH

CONTRACTOR:
GIL - TPL JV

SUBMITTED BY	GIL - TPL JV		
	DATED	NAME	SIGNATURE
PREPARED BY			
CHECKED BY	10.10.2024	VIJAY PRATAP	
APPROVED BY	10.10.2024	PARASURAM KOTYADA	

APPROVED BY	DEUTSCHE BAHN ENGINEERING & CONSULTING GMBH		
	DATED	NAME	SIGNATURE
Sr. DE./CHIEF ENGINEER		SURESH K.YALANGI	
CHIEF TRACK ENGINEER		RAJ PAL SINGH	
T.L.		H.D. VIDJAK	

STAMP
A — AS-BUILT DRAWING
TR. Ref......................
ENGINEER Sign.:

EMPLOYER (DFCCIL): DEDICATED FREIGHT CORRIDOR CORPORATION OF INDIA LTD.

AS BUILT DRAWING

TITLE
AS-BUILT PLAN AND PROFILE
FROM IR KM: 347.500 TO 348.000
FROM DFC KM: 1238.378 to 1238.852

DFCC APPR. NO. -
ENGG. APPR. NO. -
DRG. NO. -301-2/AL/A/1321
SHEET NO. : 1 OF 1
DATE : 10.10.2024
STATUS A

TR.